
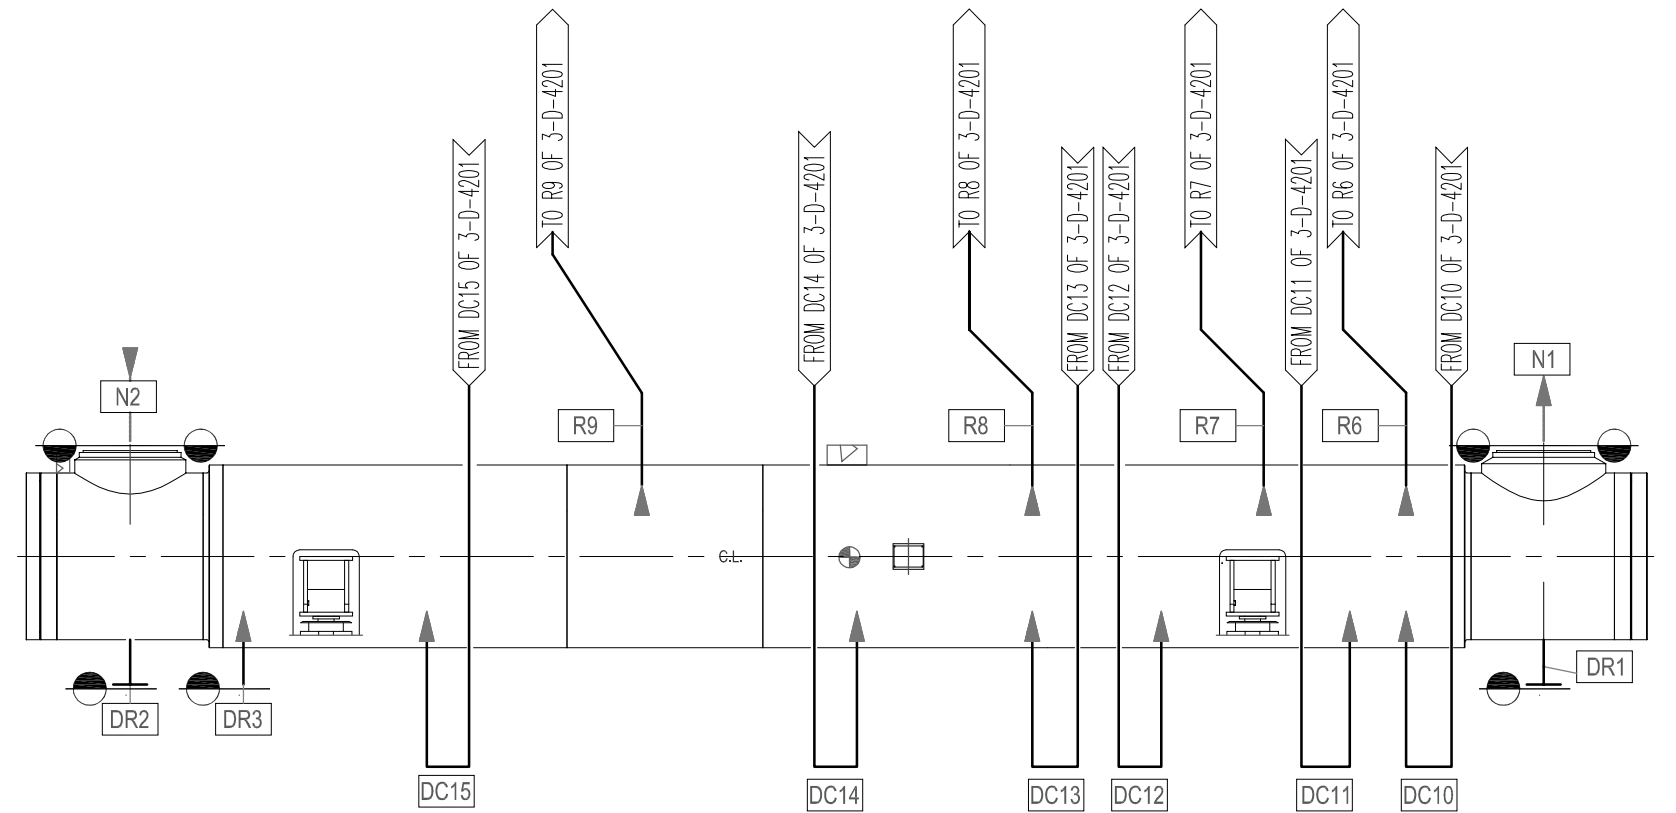



ITEM POS.	INSTRUMENT TAG NUMBER	POSITION	TYPE	SUPPLIER
01	TT 14085	3-E-1401	TEMPERATURE TRANSMITTER	YOKOGAWA
02	TV 14086	3-E-1401	TV/ACTUATOR/EP POSITIONER/ LIMIT SWITCH	ROTORK
03	PI 14099	3-D-4201	PRESSURE INDICATOR	BIOLCHI
04	PT 14100	3-D-4201	PRESSURE TRANSMITTER	YOKOGAWA
05	GV 14018	3-D-4201	GATE VALVE	BONNEY FORGE
06	GV 14019	3-D-4201	GATE VALVE	BONNEY FORGE
07	PSV 14020	3-D-4201	PRESSURE SAFETY VALVE	BOPP & REUTHER
08	PSV 14021	3-D-4201	PRESSURE SAFETY VALVE	BOPP & REUTHER
09	TT 14090	3-D-4201	TEMPERATURE TRANSMITTER	YOKOGAWA
10	---	---	---	---

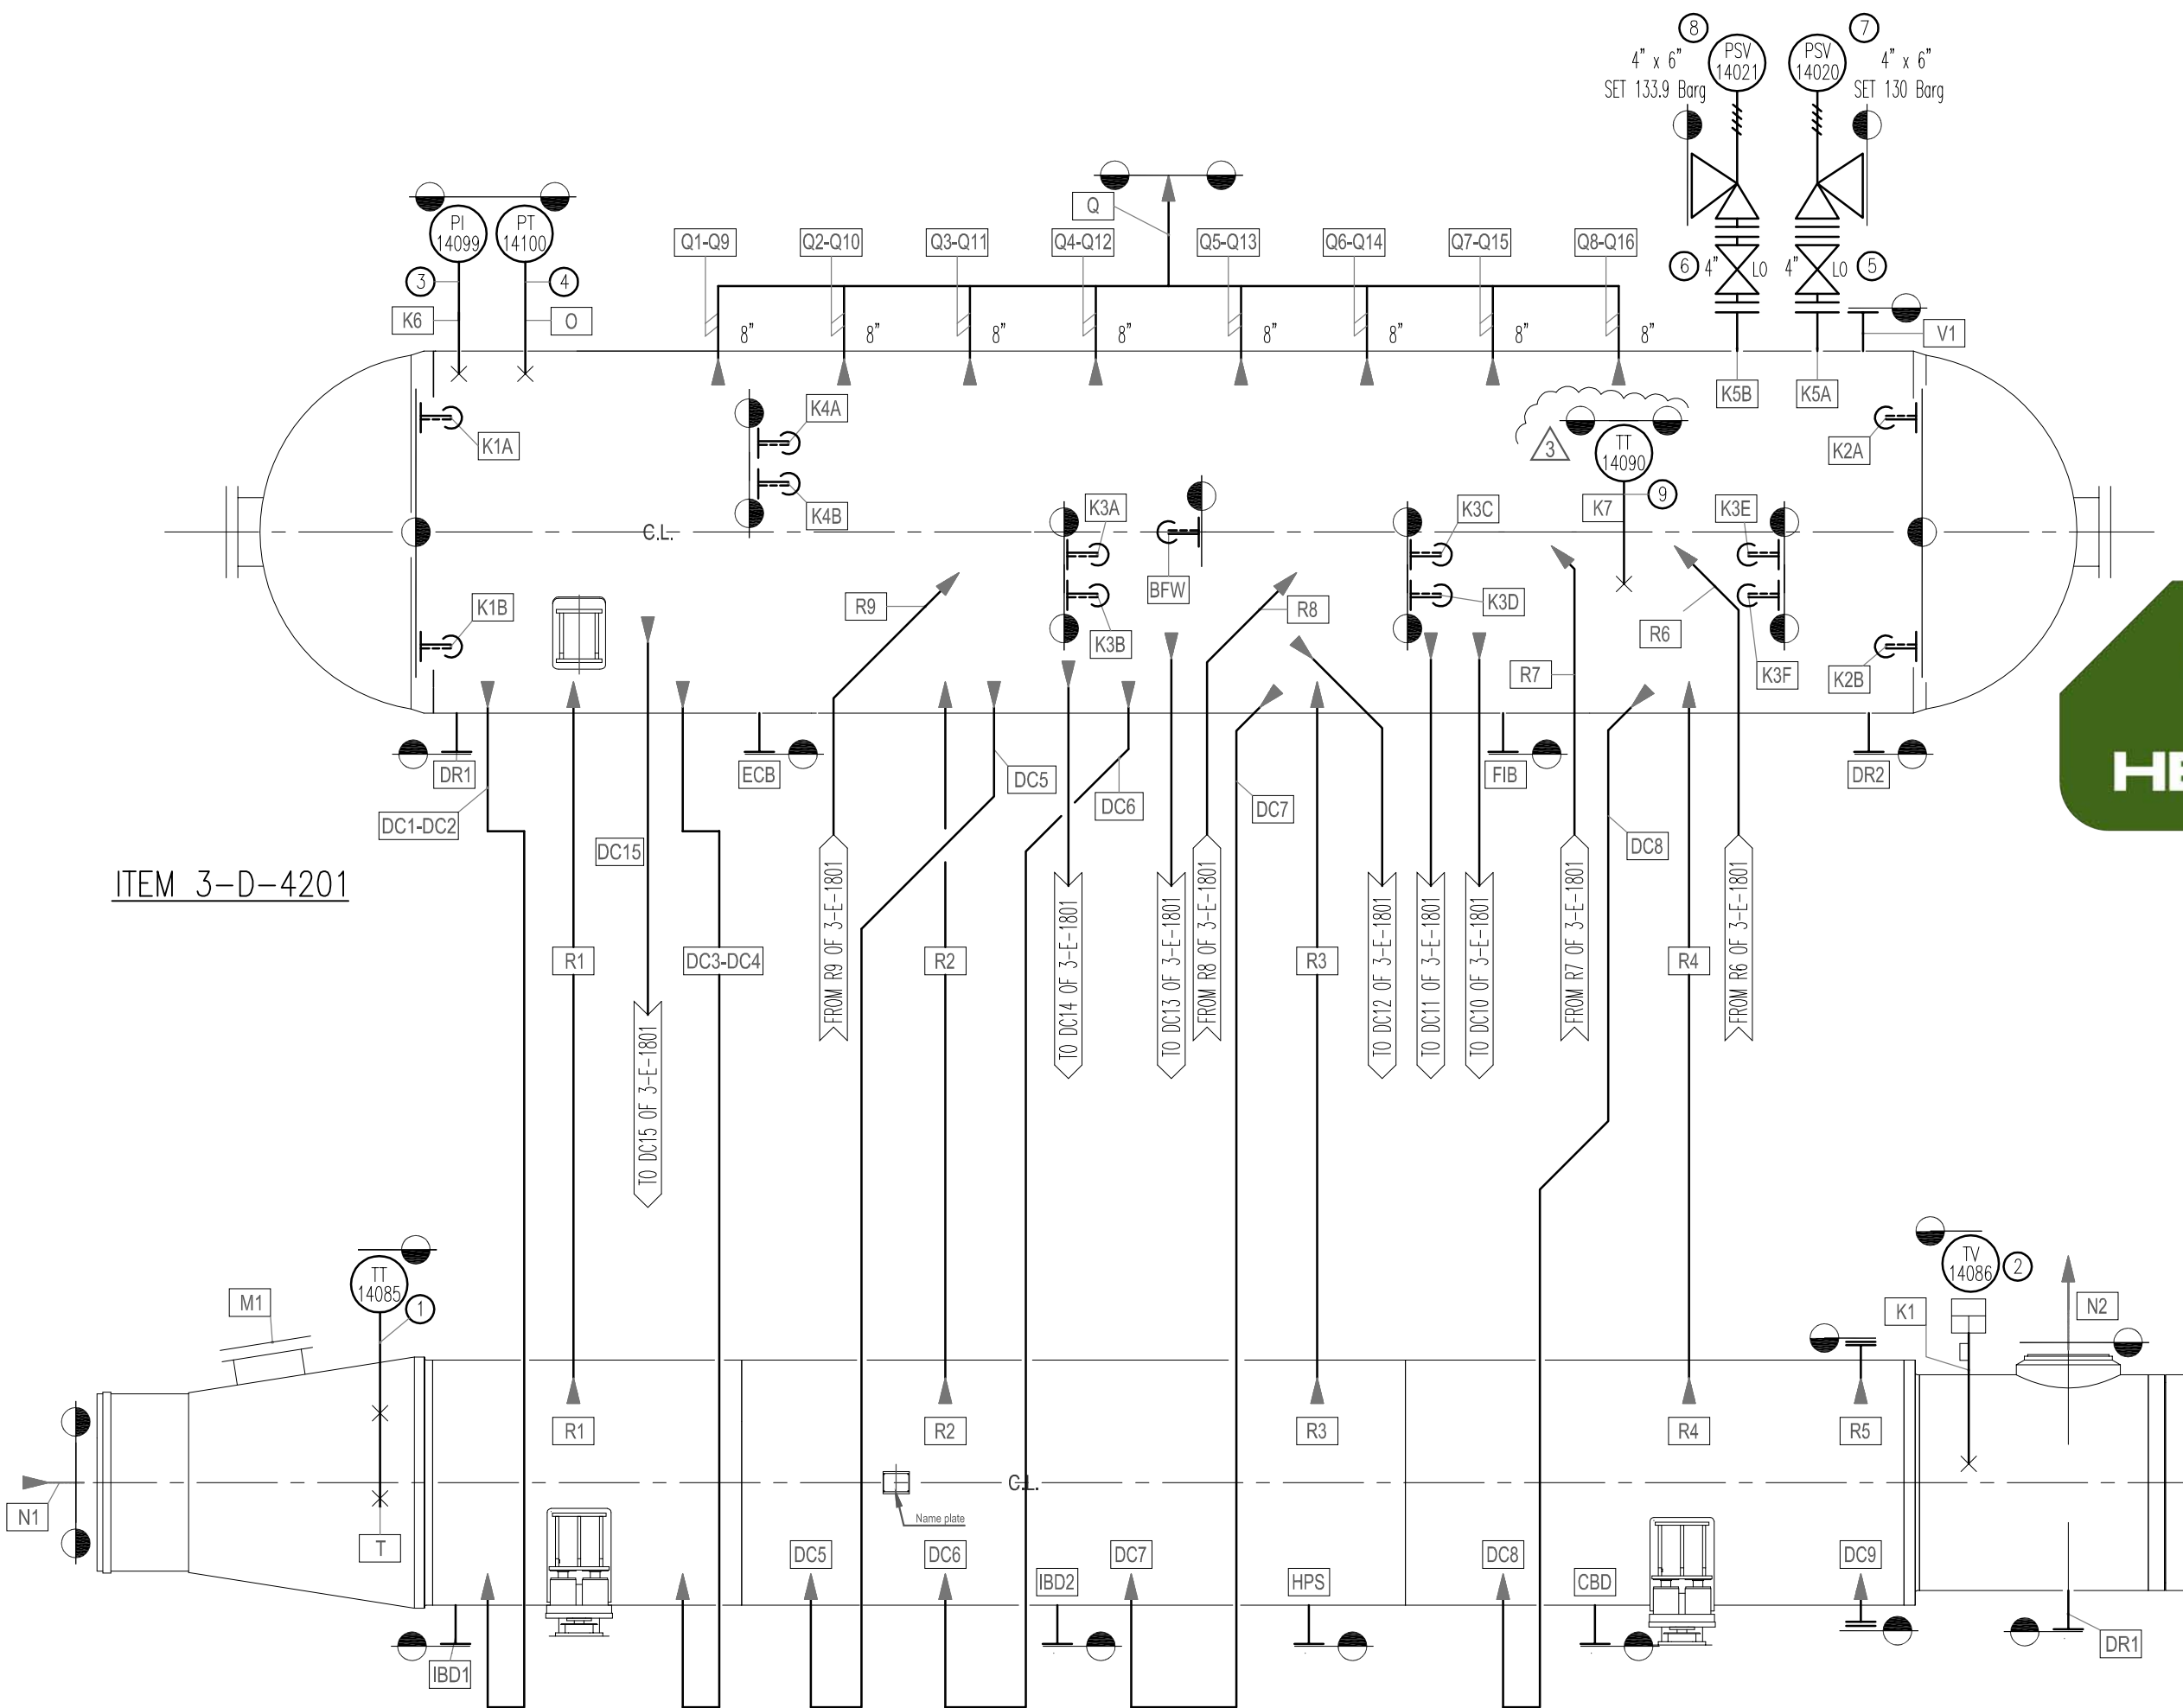

By AL OLMI
By OTHERS

LIMIT OF SCOPE OF SUPPLY

VALVES LEGENDA	
	B.W. BOTH ENDS
	FLANGED ONE END /B.W. ONE END
	FLANGED BOTH ENDS
	FLANGED BOTH ENDS WITH ONE BLIND FLANGE
	B.W. BOTH ENDS WITH ONE END PLUGGED (NIPPLE+NPTF PLUG)

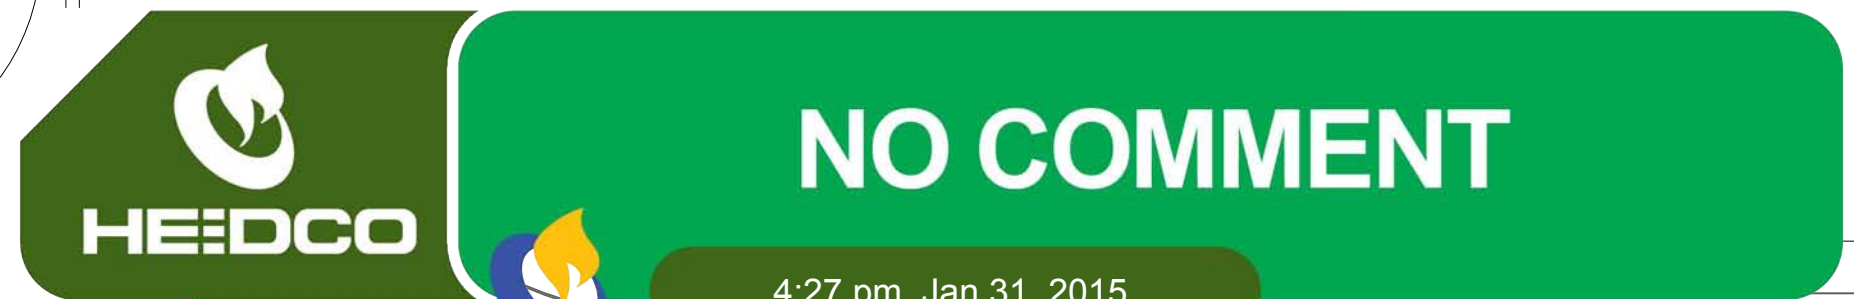

By: seraj.mohammad

4:27 pm, Jan 31, 2015

13450-R1

SUISIO - BERGAMO - ITALY		IMPIANTO E LOC. LOCATION & UNIT		Ammonia Urea Project	
TITOLO TITLE		SERVIZIO SERVICES		P. & I. & VESSEL TRIMS	
SCALA/FORMAT SCALE/FORMAT	NO / A2	TIPO / TEMA / TYPE	NUMERO APPAR. NUMBER REQUIRED	SIGLA / ITEM No.	
DATA DATE	25/10/2013	---	---	3-E-1401 & 3-D-4201 & 3-E-1801	
DISEGNATO DRAWN	Mazzoleni	DIMENSIONI / SIZE	NUM. DI FABBRICA SERIAL NUMBER	ANNO DI COS. YEAR OF CONS.	COMM. / JOB
CONTROLL. CHECKED	Zanardi	--	--	2014	7523
APPROVATO APPROVED	Sarti	--	--	7523	7523-00-PID-01
				NUM. DIS. / DWG. NUM.	REV.
				7523-00-PID-01	3

OWNER : LORDEGAN PETROCHEMICAL COMPANY		3	27/10/14	REVISED WHERE INDICATED	SP	SS	SS
PROJECT TITLE : LORDEGAN AMMONIA AND UREA PROJECT		2	03/10/14	REVISED WHERE INDICATED	SP	SS	SS
CONTRACTOR : HAMPA ENGINEERING CORPORATION		1	14/05/14	GENERAL REVISION / ISSUED FOR APPROVAL	SP	SS	SS
P.D. NO. : 2103-POR-A-HM-255		0	25/10/13	ISSUED FOR APPROVAL	PM	FG	SS
REV. NO. : 2103-REQ-A-HM-255		REV.	DATE	DESCRIPTION	DWN.	CHKD.	APPR.
DOC. NO. : 2103-A-VD-255-A-MD-108					BY	BY	BY
NO - REVIEWED WITH NO COMMENT							
C - DO NOT PROCEED WITH FABRICATION							
AC - APPROVED WITH MINOR COMMENT							
RE - DOCUMENT WAS NOT ACCEPTED							
Particular's, penalties to proceed or rectify taken on vendor jobsheet shall not release vendor from its responsibilities or liabilities under purchase order.							
OWNER: LORDEGAN PETROCHEMICAL COMPANY							
Project: LORDEGAN AMMONIA AND UREA PROJECT							
CONTRACTOR : HAMPA ENGINEERING CORPORATION							
DETAIL ENGINEER : HEIDCO							
SUISIO - BERGAMO - ITALY							
TITLE : P&ID AND INSTRUMENT LIST							
Project No:2103	HAMPA	Doc. No.	7523-00-PID-01				
Scale:		Vendor	2103-A-VD-255-A-MD-108				
Sheet of							
				REV.			
				3			

ITEM 3-D-4201

ITEM 3-E-1401

THIS DRAWING AND THE DESIGN IT COVERS IS THE PROPERTY OF LORDEGAN PETROCHEMICAL COMPANY AND ALL RIGHTS ARE RESERVED. NEITHER IN WHOLE NOR IN PART MAY BE REPRODUCED OR TRANSMITTED TO THIRD PARTY WITHOUT PRIOR WRITTEN CONSENT OF OWNER.