

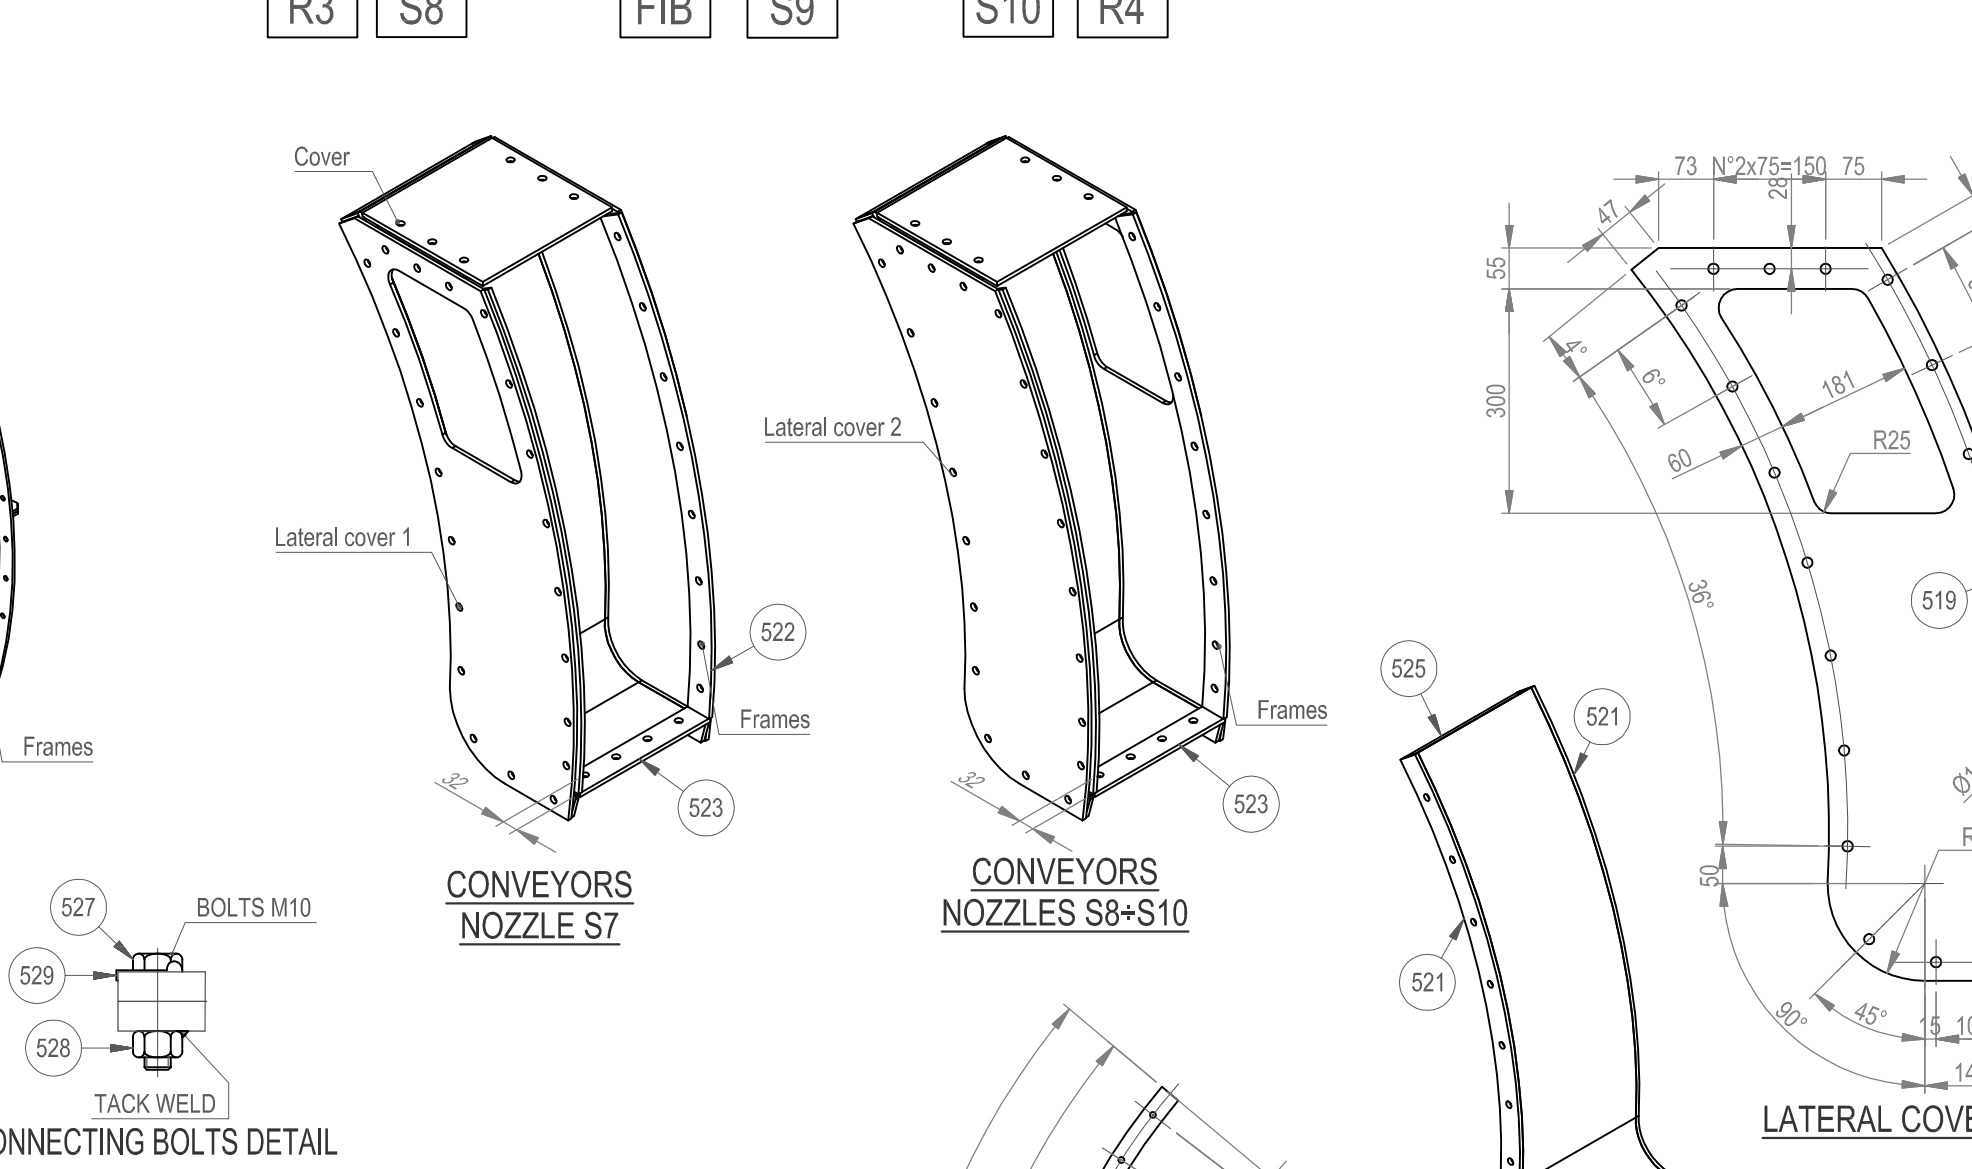
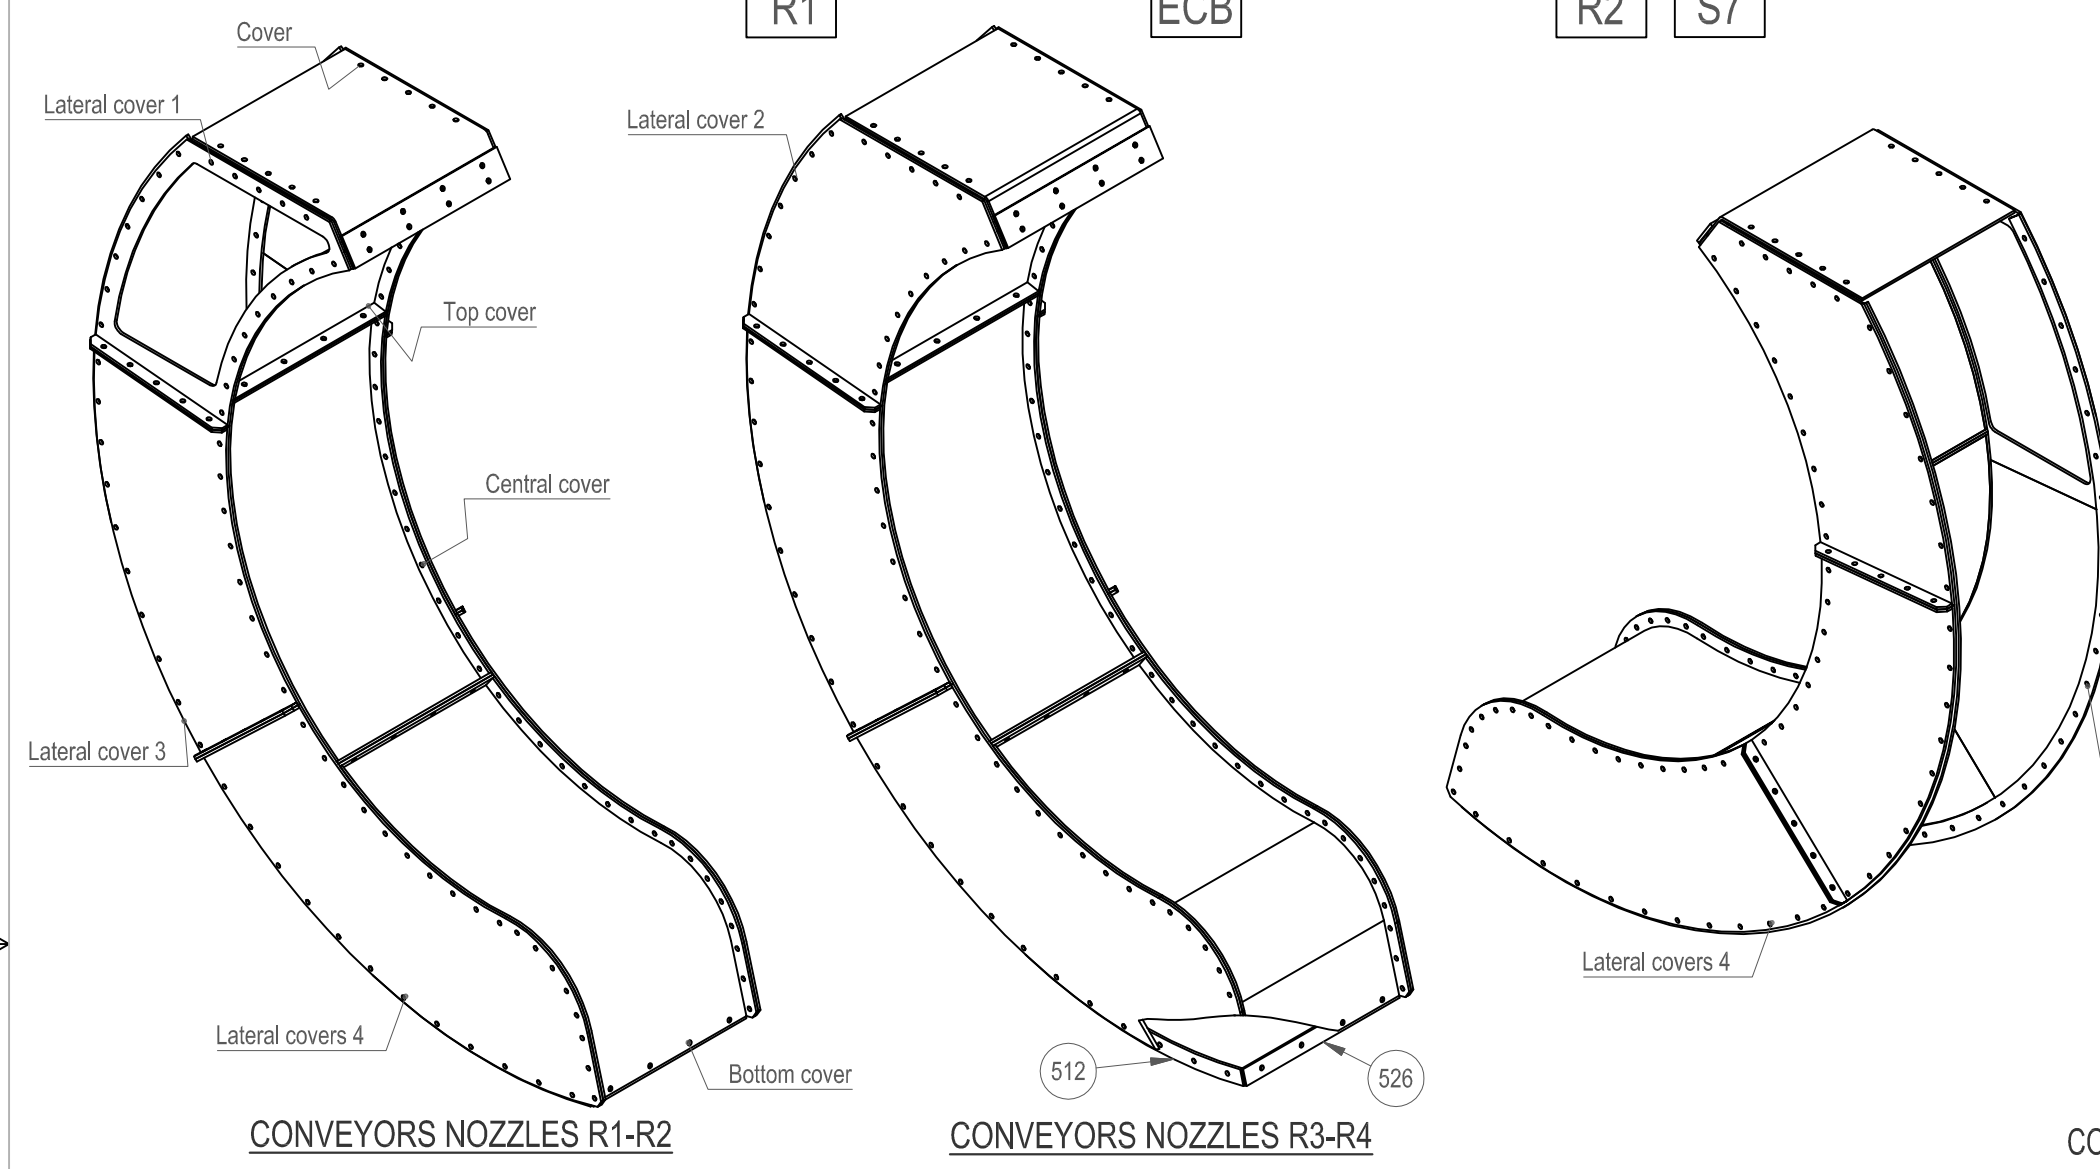
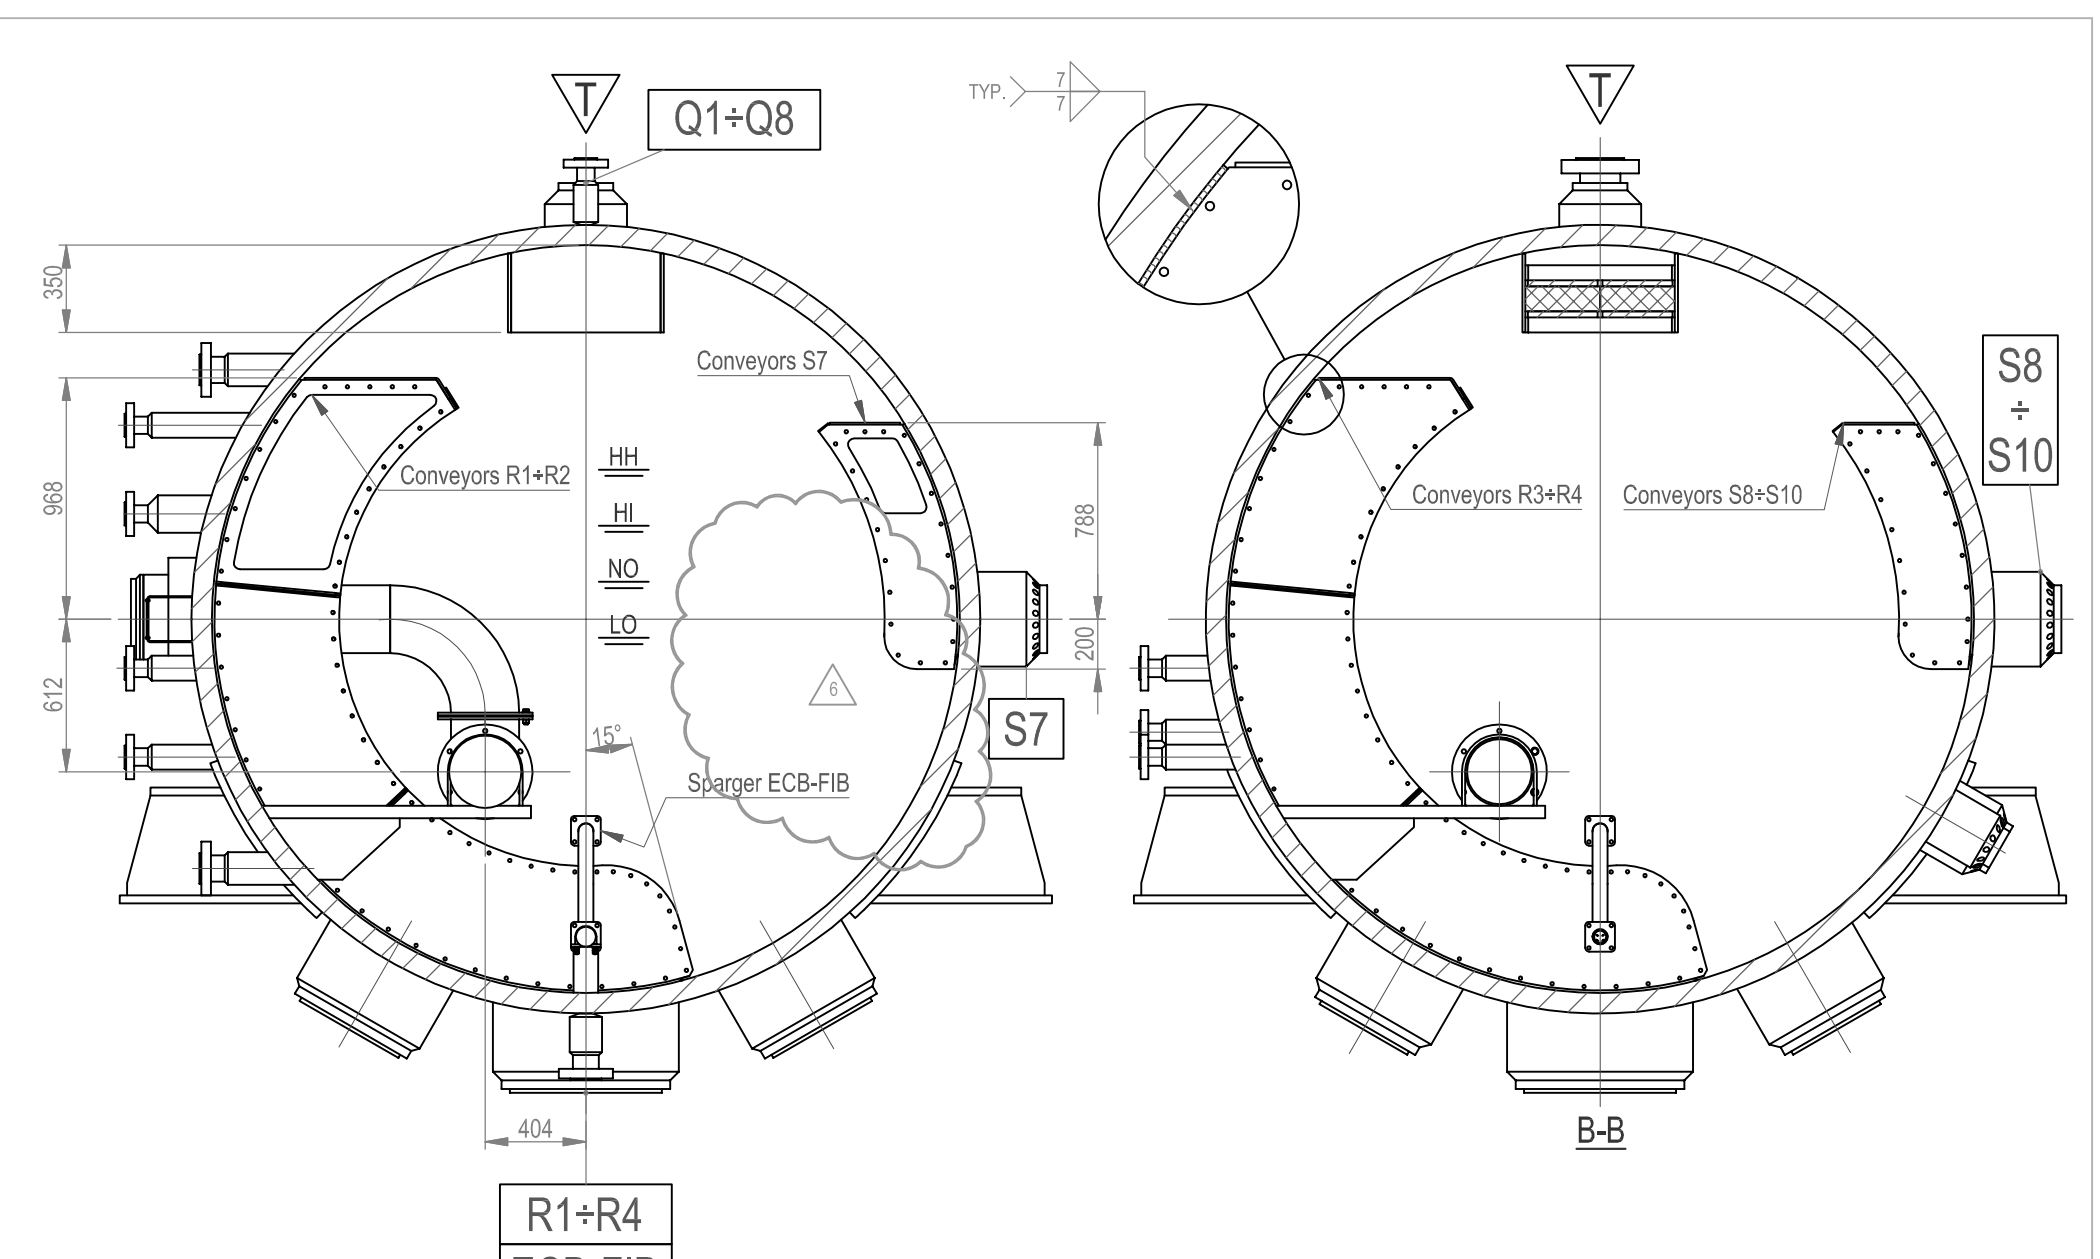
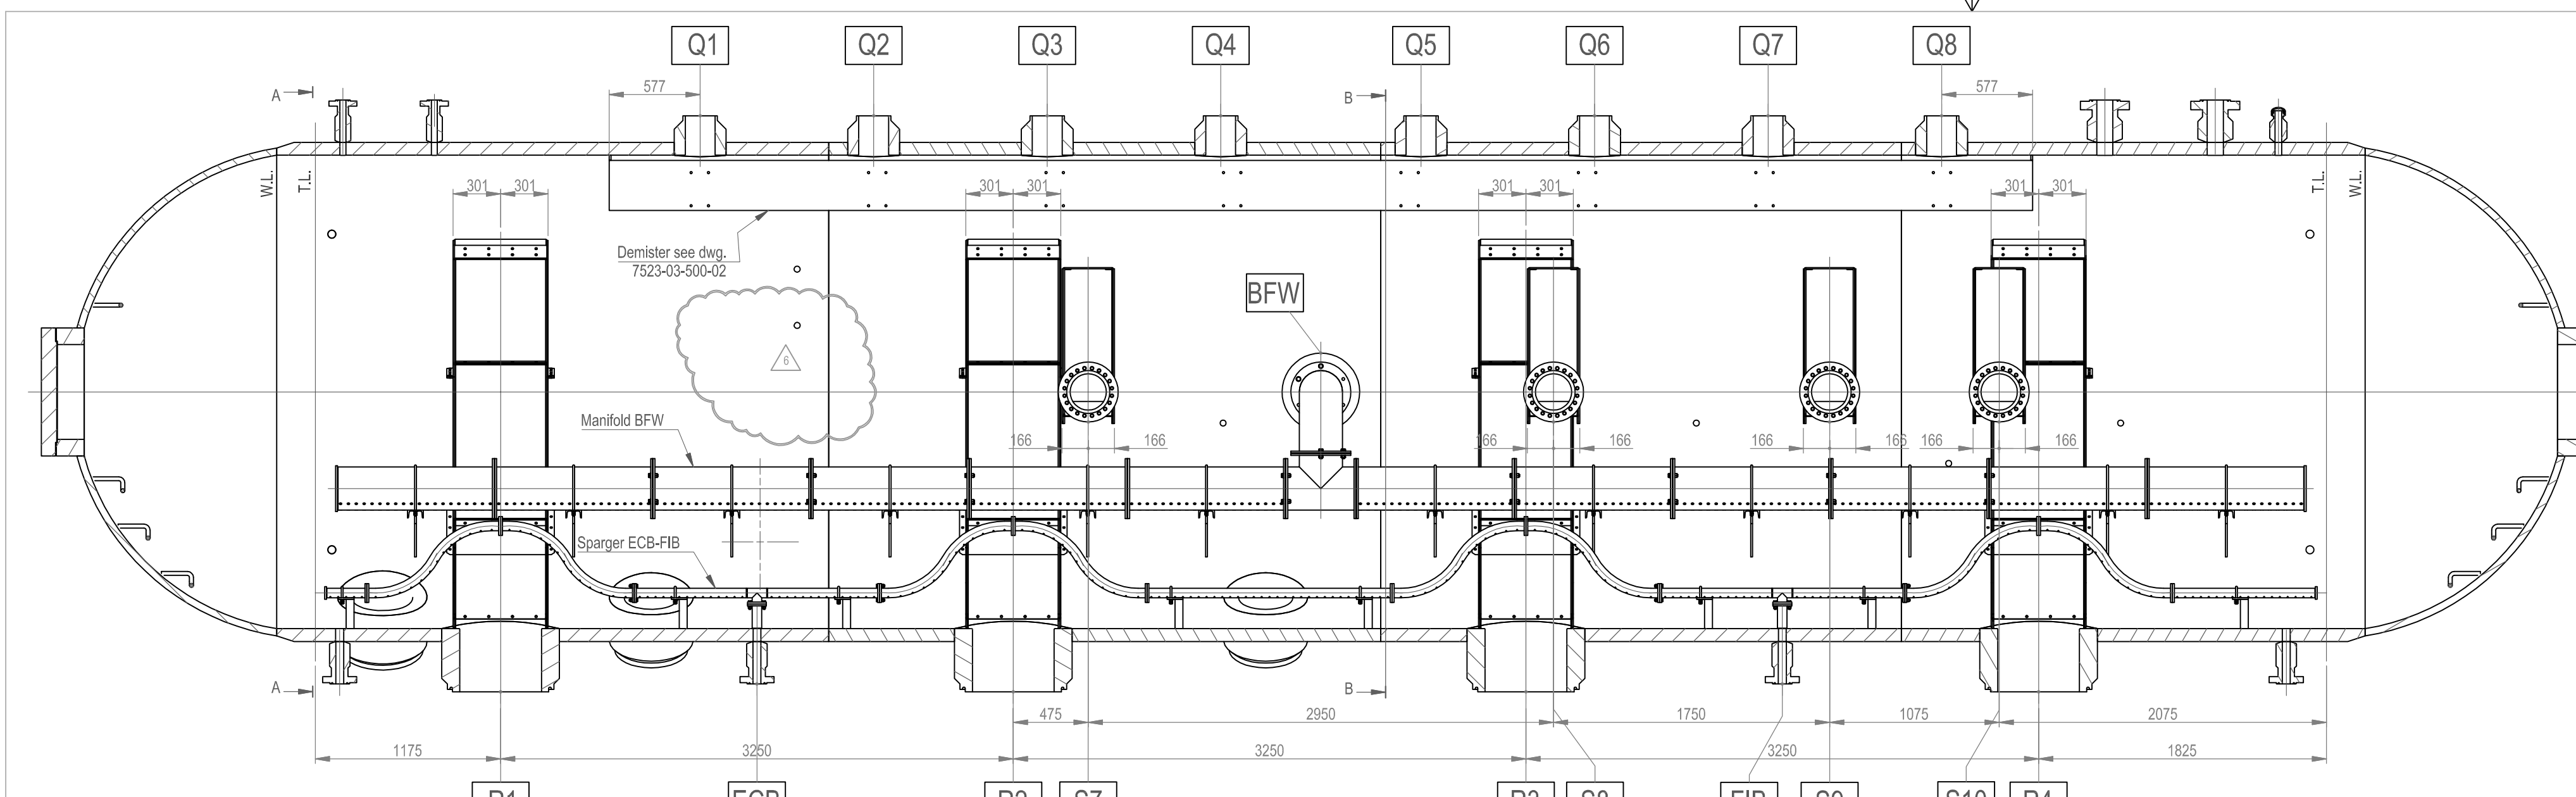


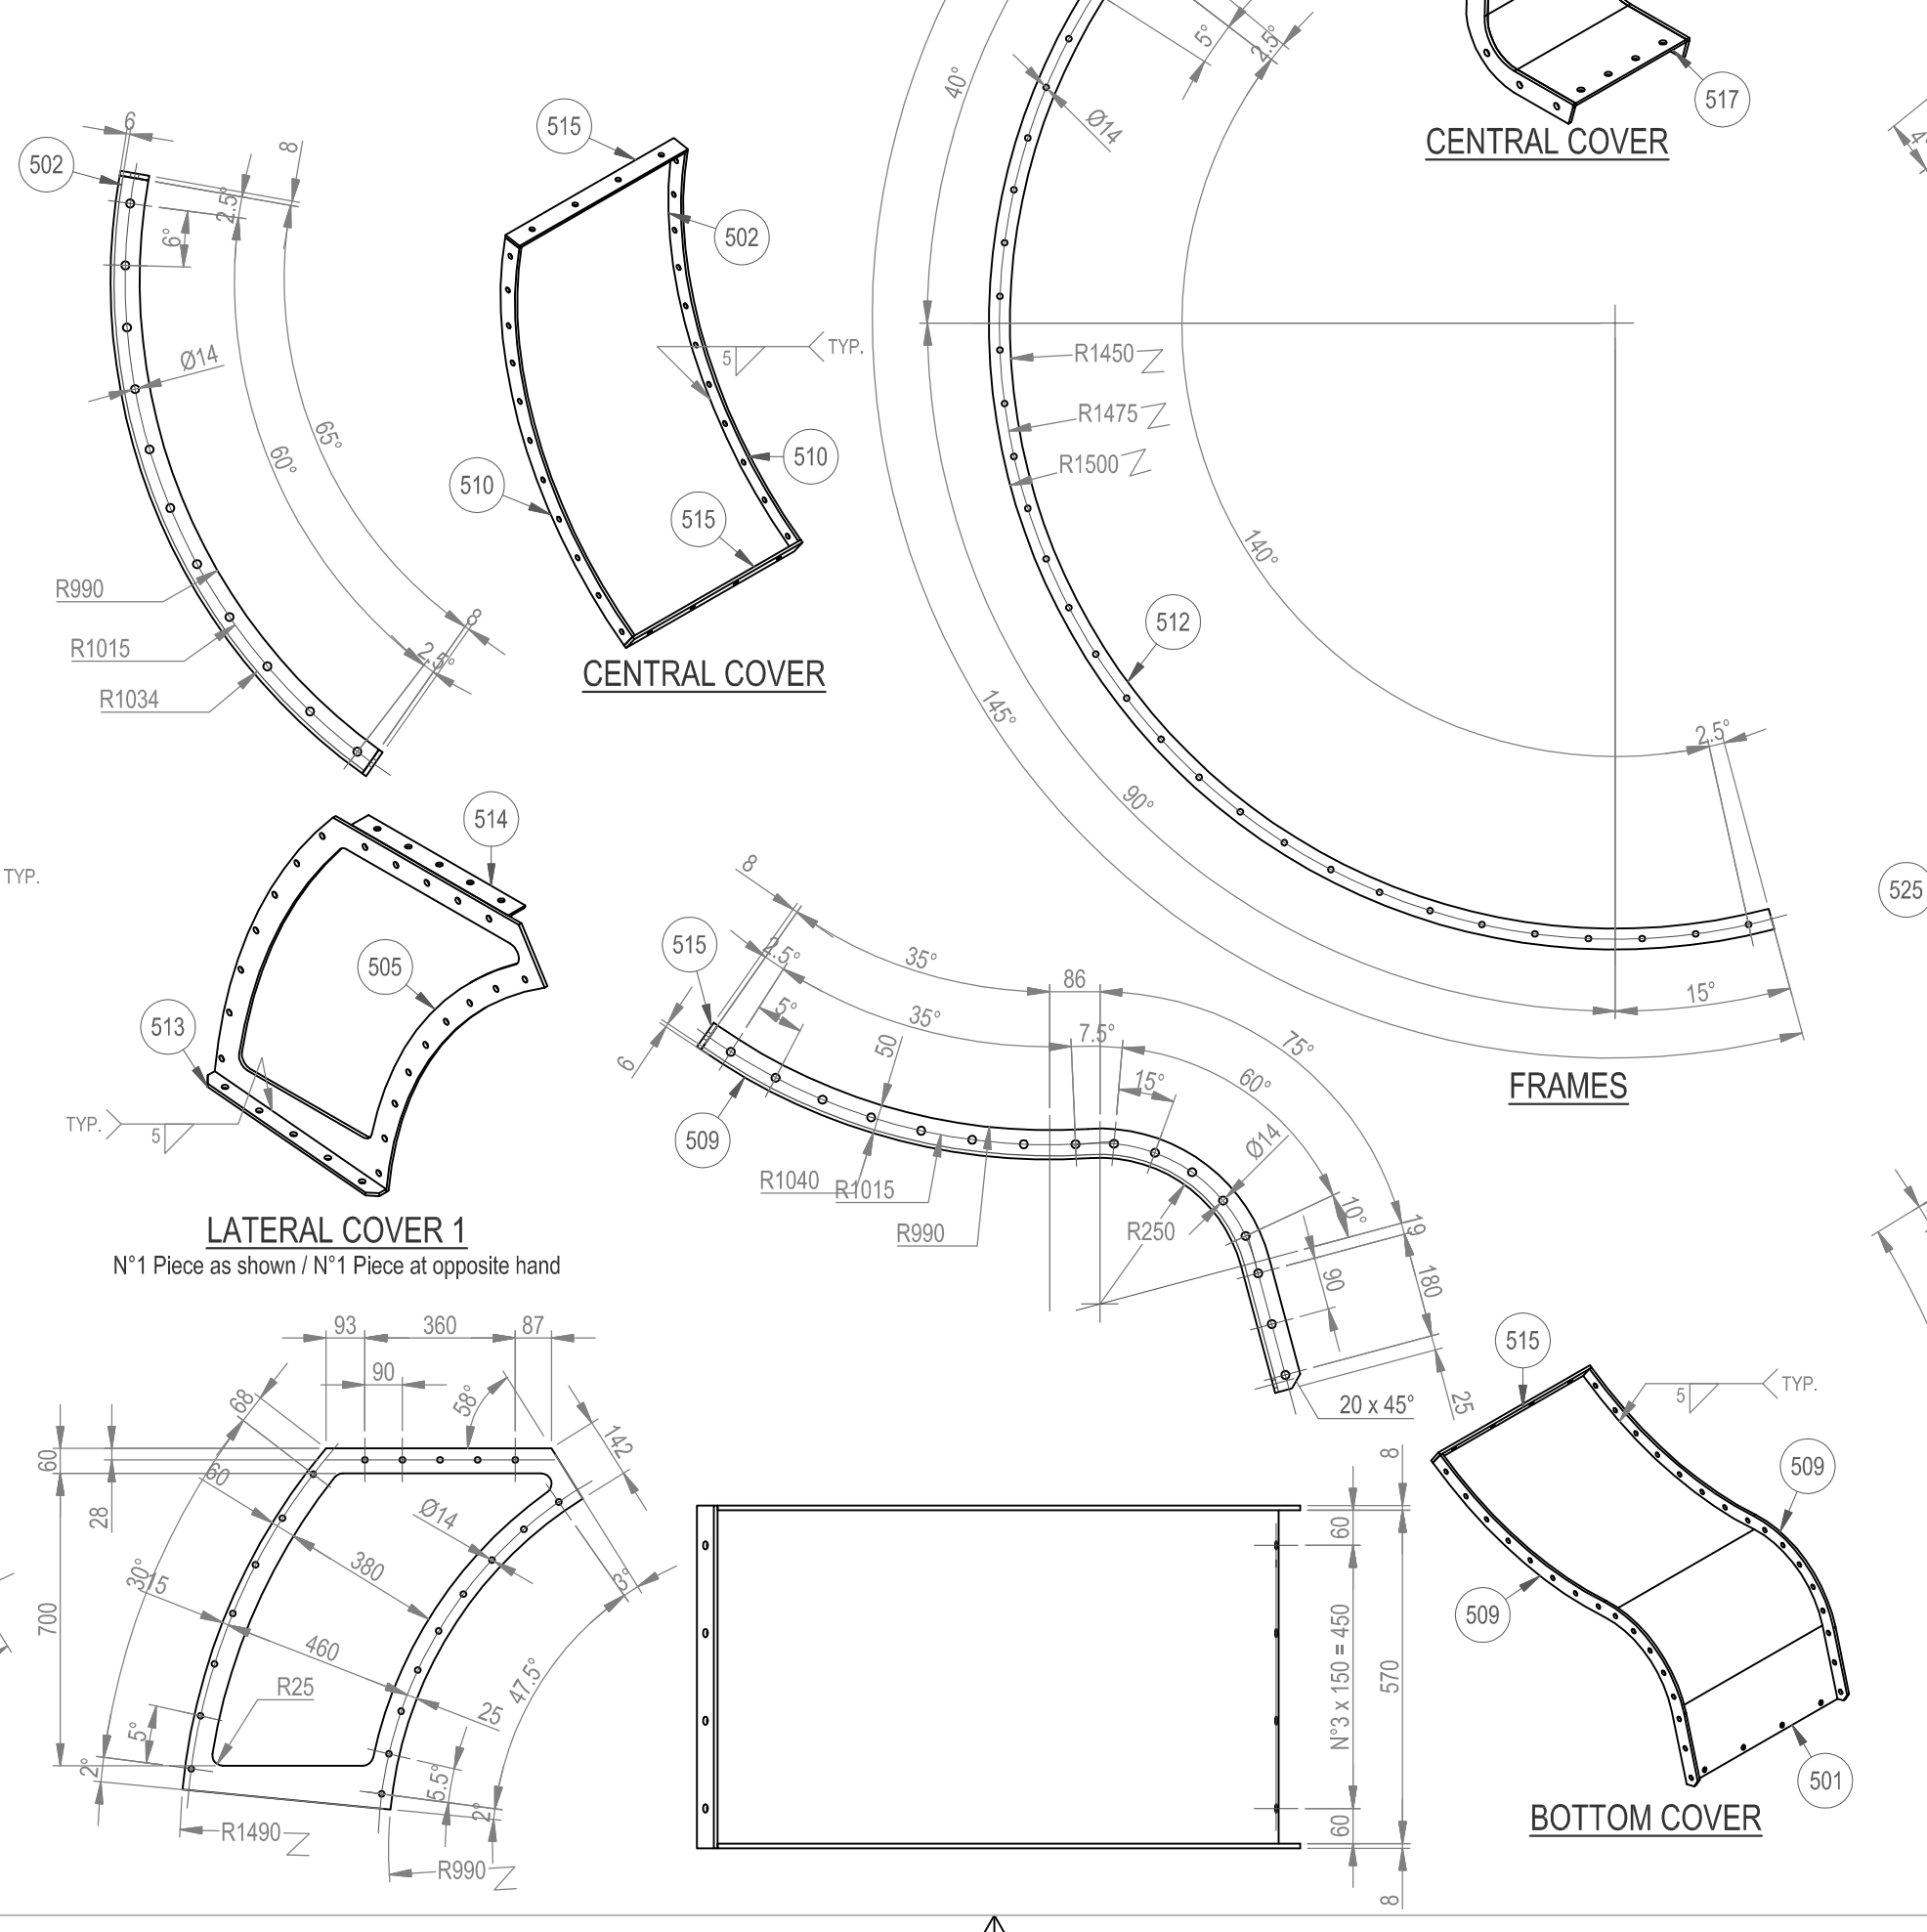

529	Rondella/Washer	M10 UNI 6800	C.S.	960	2.2				
528	Dist es./Hex. Nuts	M10 ISO 4033	6.8 ISO 888-2	960	2.2				
527	Vite/Screw	M10 x Lg.35 ISO 4018	6.8 ISO 888-1	960	2.2				
526	Platto di giunzione/Joint plate R1+R4	50 x Thk.8 Lg.578	SA-516 Gr.70N	4	3.1				
525	Platto di giunzione/Joint plate S7+S10	300 x 44 x Thk.8	SA-516 Gr.70N	4	3.1				
524	Angolare/Angle S7+S10	150 x 50 x Thk.5 Lg.210	SA-36	8	2.2				
523	Platto di giunzione/Joint plate S7+S10	308 x 50 x Thk.8	SA-516 Gr.70N	4	3.1				
522	Combie laterale/Lat. Frame S7+S10	50 x Thk.8 Lg.967	SA-516 Gr.70N	8	3.1				
521	Platto di giunzione/Joint plate S7+S10	50 x Thk.8 Lg.1240	SA-516 Gr.70	8	3.1				
520	Coperchio/Cover S7+S10	306 x 284 x Thk.8	SA-516 Gr.70N	4	3.1				
519	Coperchio laterale/Lateral cover S7+S10	980 x 542 x Thk.8	SA-516 Gr.70N	4	3.1				
518	Coperchio laterale/Lateral cover S7+S10	980 x 542 x Thk.8	SA-516 Gr.70N	4	3.1				
517	Coperchio cent./Central cover S7+S10	1210 x 300 x Thk.6	SA-516 Gr.70N	4	3.1				
516	Platto di giunzione/Joint plate R1+R4	95 x Thk.8 Lg.586	SA-516 Gr.70N	4	3.1				
515	Platto di giunzione/Joint plate R1+R4	50 x Thk.8 Lg.586	SA-516 Gr.70N	20	3.1				
514	Angolare/Angle R1+R4	150 x 50 x Thk.5 Lg.455	SA-36	8	2.2				
513	Platto di giunzione/Joint plate R1+R4	40 x Thk.8 Lg.500	SA-516 Gr.70N	32	3.1				
512	Combie laterale/Lat. Frame R1+R4	50 x Thk.8 Lg.3788	SA-516 Gr.70N	8	3.1				
511	Platto di giunzione/Joint plate R1+R4	50 x Thk.8 Lg.656	SA-516 Gr.70N	8	3.1				
510	Platto di giunzione/Joint plate R1+R4	50 x Thk.8 Lg.1170	SA-516 Gr.70N	8	3.1				
509	Platto di giunzione/Joint plate R1+R4	50 x Thk.8 Lg.1290	SA-516 Gr.70N	8	3.1				
508	Coperchio/Cover R1+R4	625 x 576 x Thk.8	SA-516 Gr.70N	4	3.1				
507	Coperchio laterale/Lateral cover R1+R4	1169 x 765 x Thk.8	SA-516 Gr.70N	8	3.1				
506	Coperchio laterale/Lateral cover R1+R4	865 x 958 x Thk.8	SA-516 Gr.70N	4	3.1				
505	Coperchio laterale/Lateral cover R1+R4	865 x 958 x Thk.8	SA-516 Gr.70N	4	3.1				
504	Coperchio laterale/Lateral cover R1+R4	1560 x 810 x Thk.8	SA-516 Gr.70N	8	3.1				
503	Coperchio sup./Top cover R1+R4	856 x 570 x Thk.6	SA-516 Gr.70N	4	3.1				
502	Coperchio centrale/Central cover R1+R4	1170 x 570 x Thk.6	SA-516 Gr.70N	4	3.1				
501	Coperchio inf./Bottom cover R1+R4	1290 x 570 x Thk.6	SA-516 Gr.70N	4	3.1				

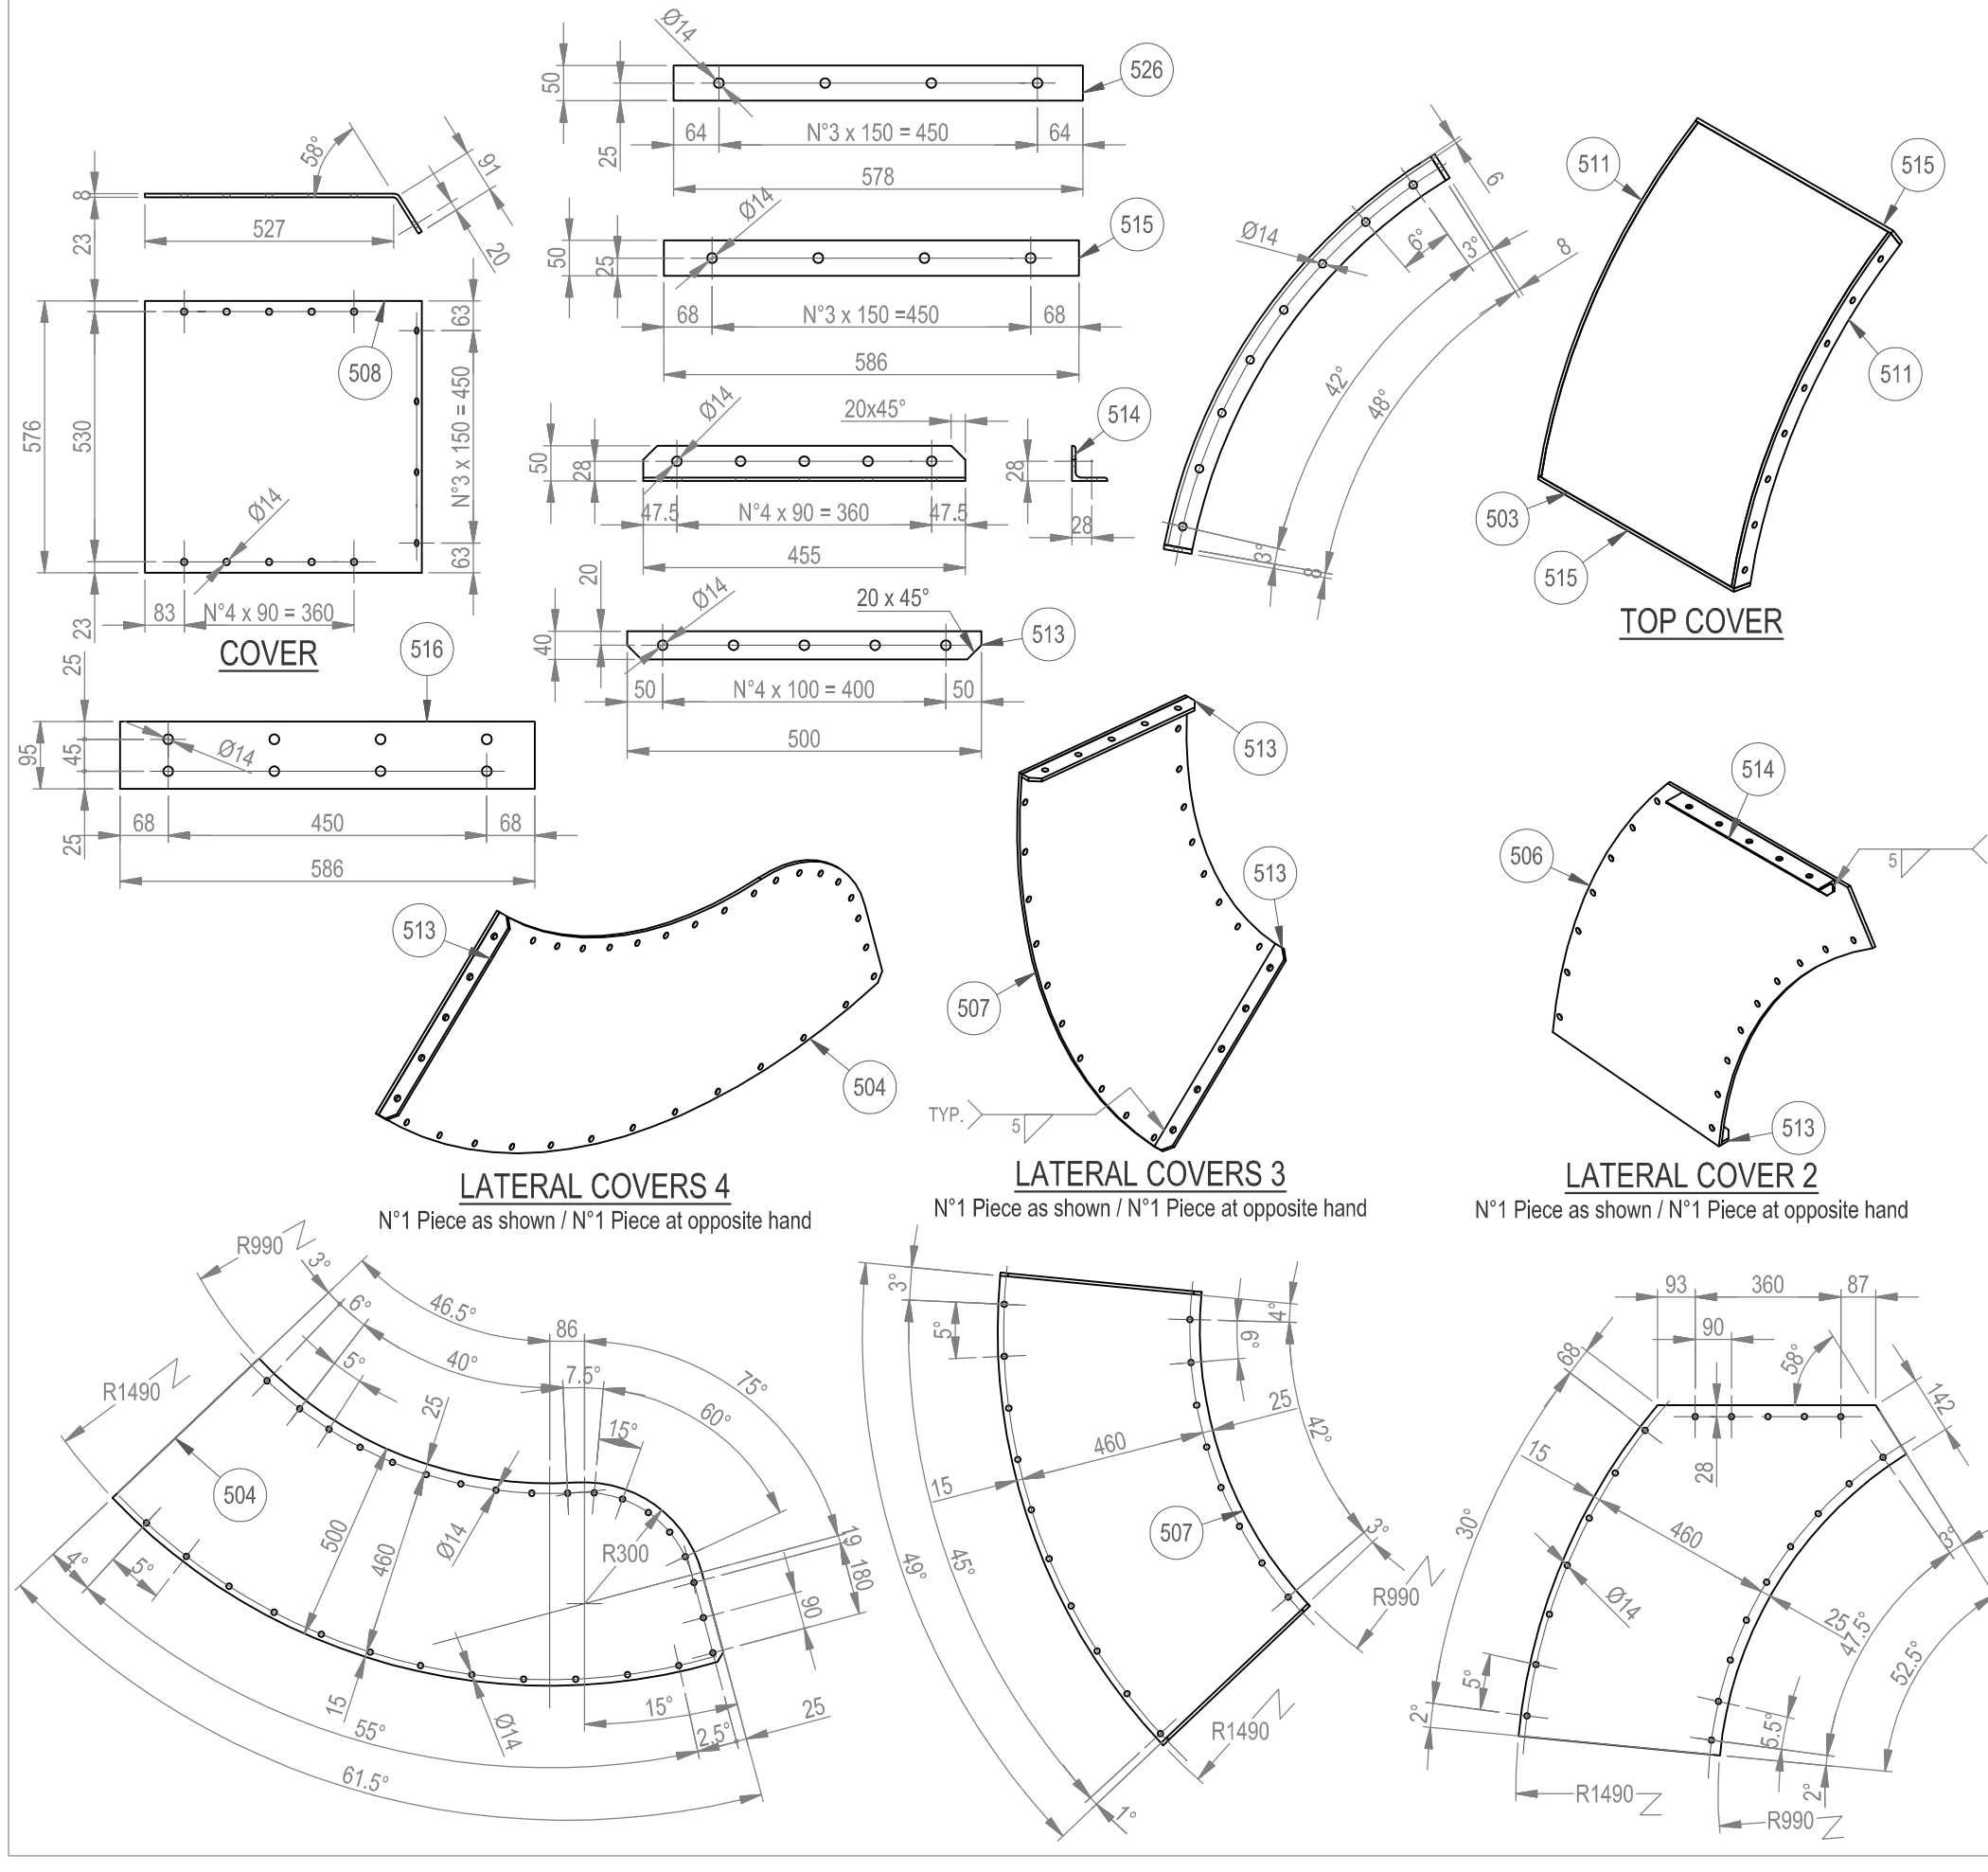

By: seraj.mohammad

8:49 am, Oct 26, 2015

3	25/09/2015	Revised as per client comments	Scorti	Sarti	Sarti
2	19/11/2014	Added water steam chimney, revised where marked & released 'AS BUILT'	Scorti	Sarti	Sarti
1	02/12/2013	Final issued	Mazzoleni	Sarti	Sarti
0	29/04/2013	Issued for approval	Mazzoleni	Sarti	Sarti

REV.	DATE	DESCRIPTION	PREPARED	CHECKED	APPROVED

CLIENTE / CUSTOMER	Fimco
ORDINE CLIENTE / PURCHASE ORDER	FZMC-13450-R1
IMPIANTO E LOC. / LOCATION & UNIT	Ammonia Urea Project
SERVIZIO / SERVICES	Steam Drum
TITOLO / TITLE	Internal parts drawing

SCALE/FORMAT	NO / A1	NUMERO APPAR. / NUMBER REQUIRED	1	SIGLA / ITEM No.	3-D-4201
DATA / DATE	29/04/2013	N.A.			
DISegnato / DRAWN	Mazzoleni				
Controllato / CHECKED	Sarti				
Approvato / APPROVED	Sarti				

NUM. DI FABBRICA / SERIAL NUMBER	12544	ANNO DI COS. / YEAR OF CONS.	2014	COMM. / JOB	7523	NUM. DIS. / DWG. NUM.	7523-03-500-01	REV.	3
----------------------------------	-------	------------------------------	------	-------------	------	-----------------------	----------------	------	---

AS BUILT

Project: 7523-03-500-01

Contractor: HAMP Engineering Corporation

Owner: LORDEGAN PETROCHEMICAL COMPANY

Project No: 2103	Vendor	Doc. No.	7523-03-500-01	Rev.	3
------------------	--------	----------	----------------	------	---